


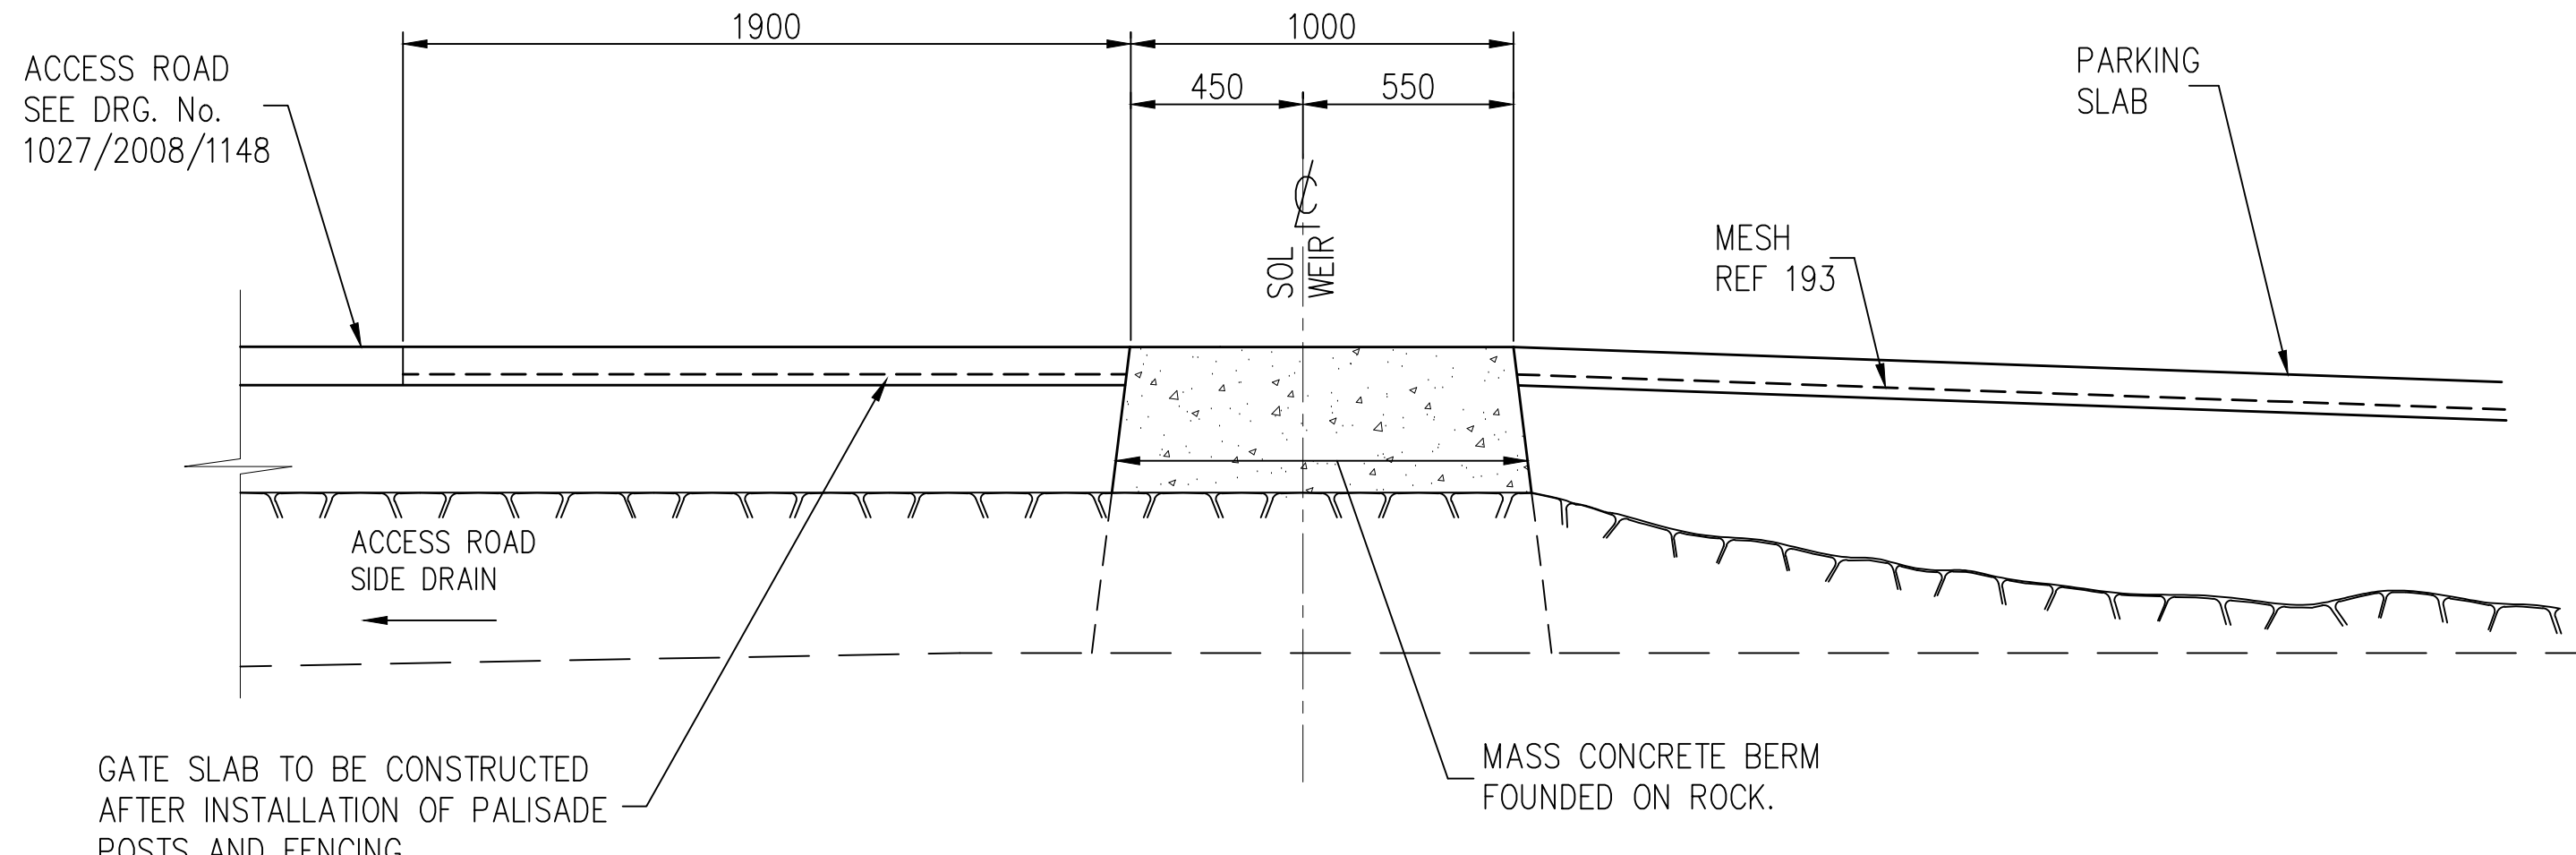


SECTION X



1. ALL DIMENSIONS ARE IN MILLIMETRES UNLESS SHOWN OTHERWISE.
2. ALL LEVELS ARE IN METRES ABOVE MEAN SEA LEVEL.
3. CONCRETE CLASS 30/19
4. REINFORCEMENT – MESH REF 193 – PLACED CENTRE OF SECTION
5. ORDER OF PLACING – ALTERNATE PANELS
6. SURFACE FINISH U5
7. SEPTIC TANK – PREFABRICATED HDPE TANK – "CALCAMITE
1750 Litres"
8. CONSTRUCTION DETAILS OF PALISADE FENCING TO BE DISCUSSED
WITH CONTRACTOR ON SITE.
9. FINAL POSITION OF SECURITY FENCING TO BE INDICATED BY
THE ENGINEER ON SITE.

RELATED DRAWINGS	
DRG. No.	DESCRIPTION
1117	ROADS – TYPICAL CROSS SECTION
1148	ROADS – ROAD No. 1 FROM ACCESS ADIT TO WEIR
1402	GATE & FENCE DETAILS
2001	WEIR AND INTAKE – INTAKE EXCAVATION PLAN
2309	STORE ROOM GENERAL ARRANGEMENT
2310	GUARD HOUSE GENERAL ARRANGEMENT
2707	INTAKE – MISCELLANEOUS STEELWORK – SHT 3 OF 3

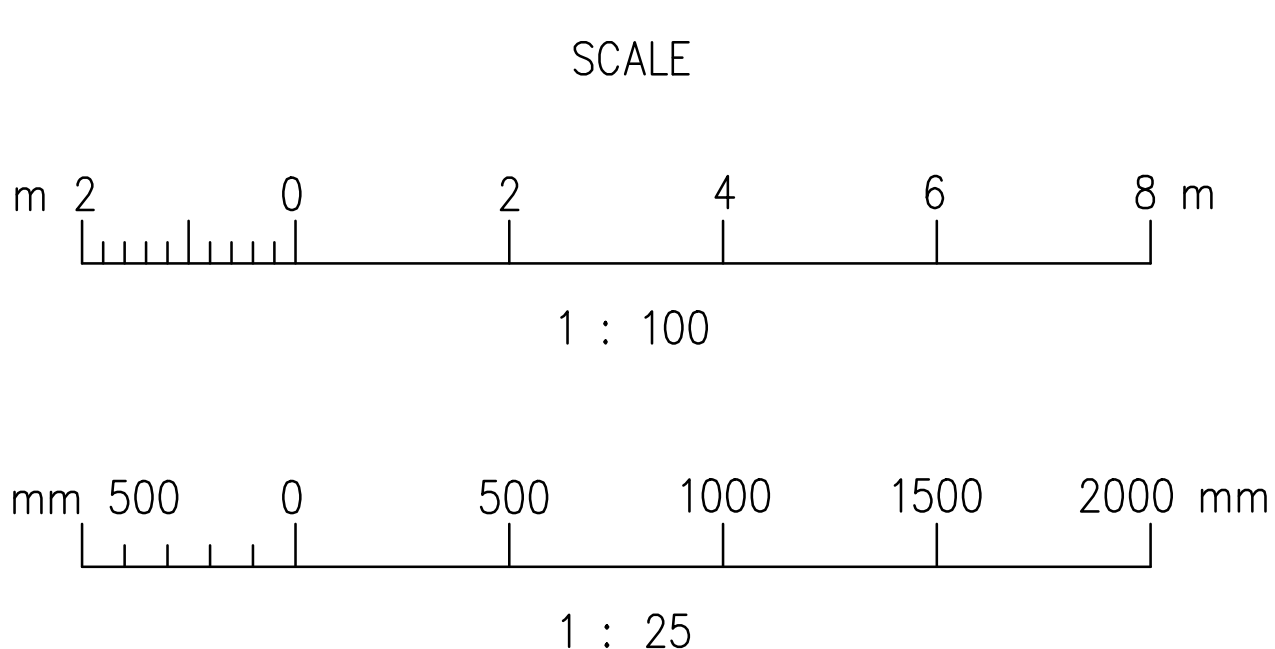

04.01	Z	AS BUILT	OGK		
03.99	0	Issued for information and comment.	OGK	CJA	EAM
Date	Rev.	Amendment	Dr.	Ch.	App.


KINGDOM OF LESOTHO
LESOTHO HIGHLANDS DEVELOPMENT AUTHORITY

LESOTHO HIGHLANDS WATER PROJECT
MATSOKU TUNNEL AND WEIR

INTAKE

PARKING AREA

GENERAL LAYOUT & DETAILS

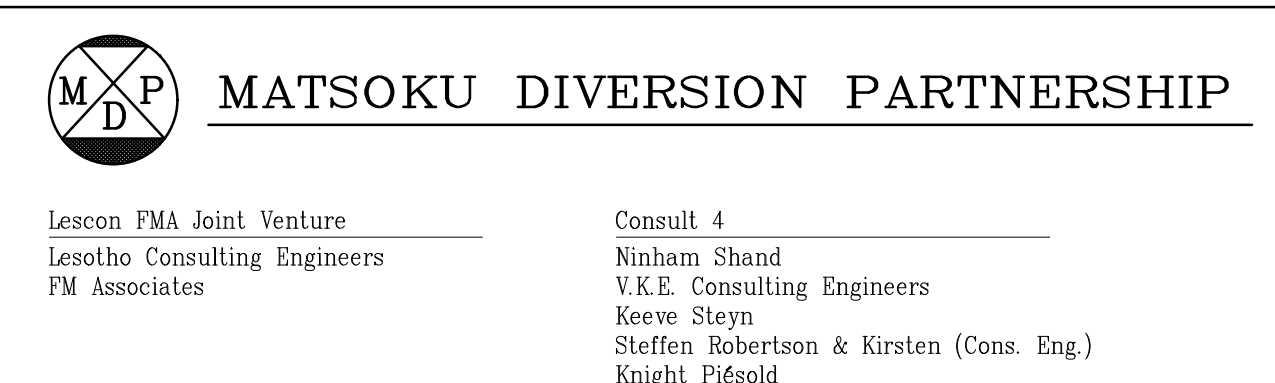

	Date	Drawing no.	Rev.
	JAN. 99	1027/2008/ 2306	Z
Project Manager			